


01 LEVEL THREE
SCALE 1:100

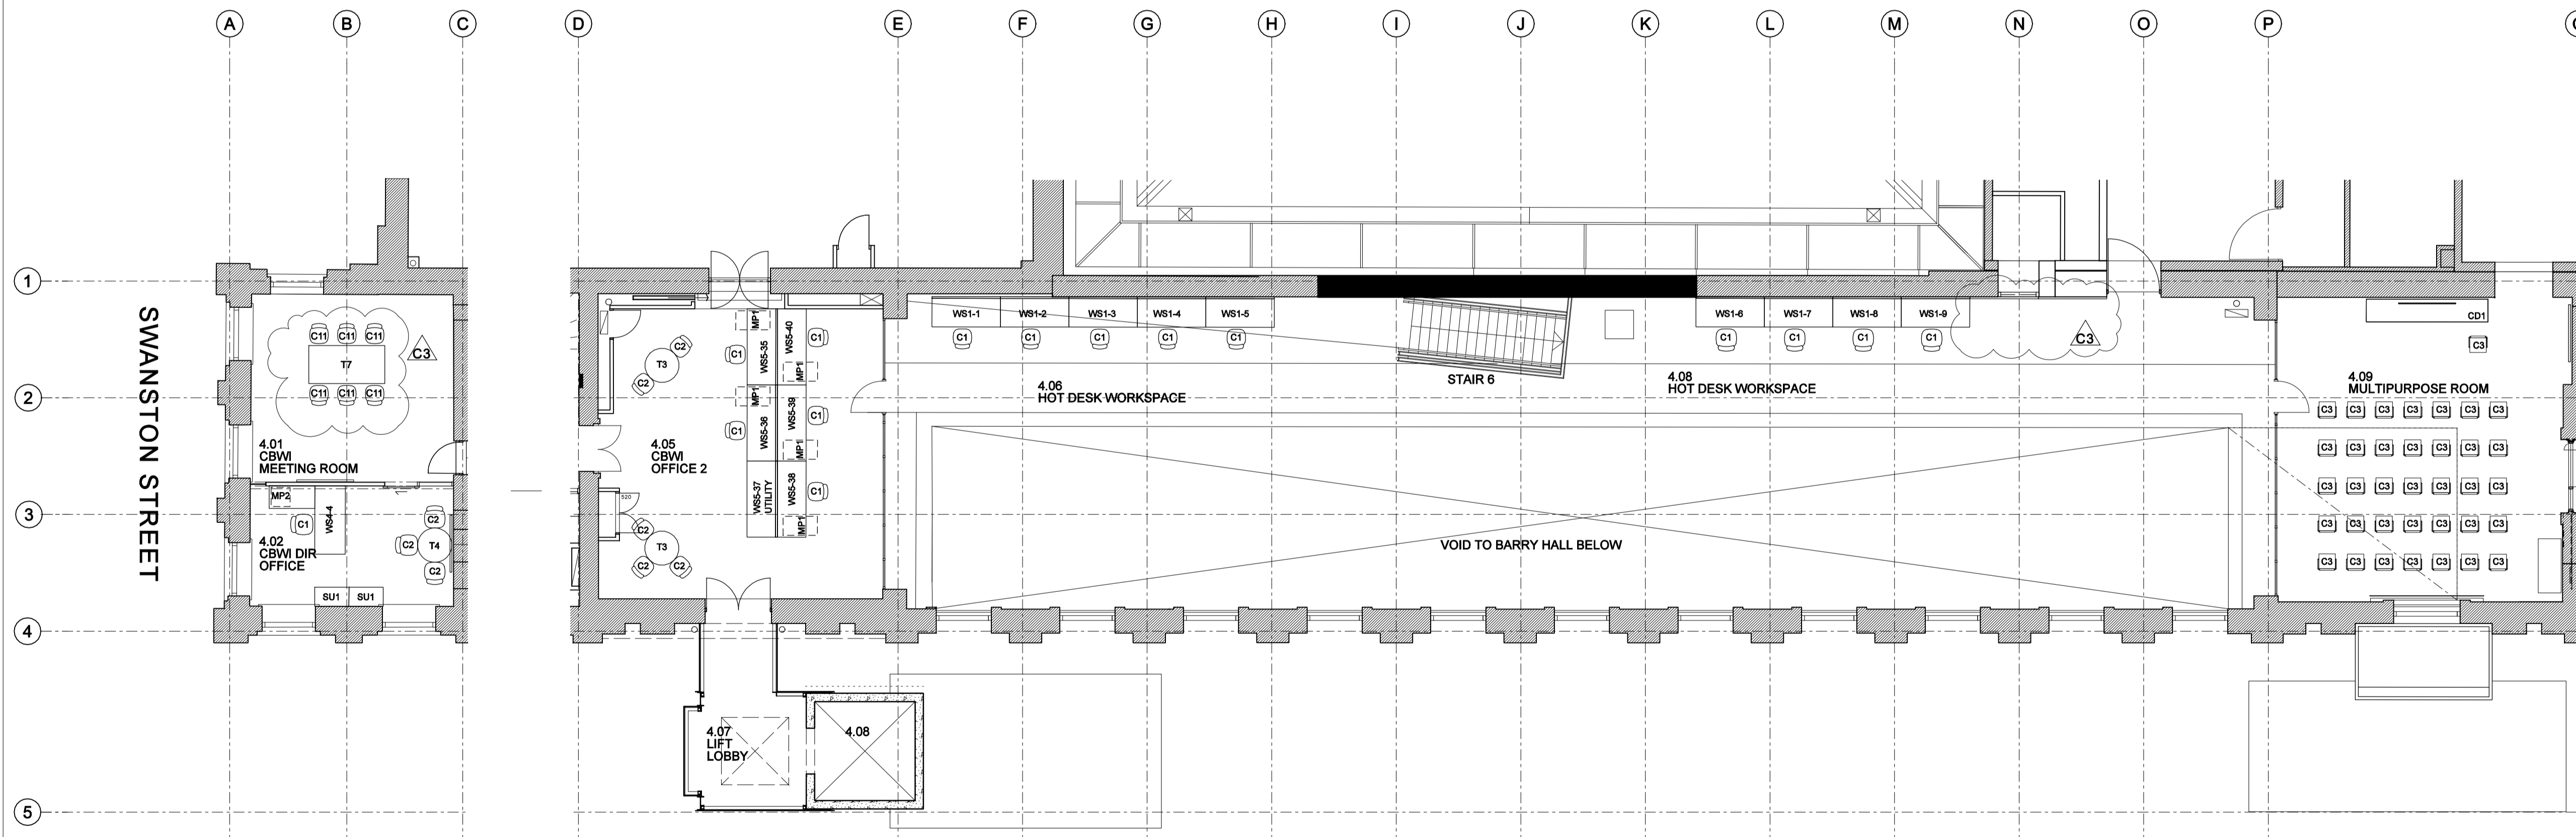

02 LEVEL FOUR
SCALE 1:100

Furniture & Workstation Legend

WS1	Workstation Type 1
WS2	Workstation Type 2
WS3	Workstation Type 3
WS4	Workstation Type 4
WS5	Workstation Type 5
MP1	Mobile Pedestal Type 1
MP2	Mobile Pedestal Type 2
C1	Task Chair
C2	Office Visitors Chair
C3	Stacking Chair
C4	Boardroom Chair
C5	Lounge Chair Type 1
C6	Lounge Chair Type 2
C6A	Lounge Chair Type 3
C7	Stool Type 1
C8	Stool Type 2
C9	Lounge Chair Type 4
C10	Stool Type 3
C11	Meeting Chair
T1	Boardroom Folding Tables
T2	Coffee Table Type 1
T3	Meeting Table
T4	Office Meeting Table
T5	Bar Table
T6	Coffee Table Type 2
T7	Meeting Table Type 2
T8	Meeting Table Type 3
P1	Platform
ST	Stair
CD1	Credenza
SU1	Storage Unit Type 1
SU2	Storage Unit Type 2
SU3	Storage Unit Type 3
RU1	Rug Type 1
RU2	Rug Type 2
RU3	Rug Type 3
RU4	Rug Type 4
J1-J20	Joinery Units 1-20

CONSTRUCTION DOCUMENTS

Rev.	Date	Revision	Prep'd
C3	07.09.09	Furniture changes to 3.17, 4.01 + 4.08.	PH

GENERAL NOTES

- ALL DRAWINGS ARE TO BE READ WITH OTHER CONTRACT DOCUMENTS INCLUDING SPECIFICATIONS, SCHEDULES, BASE BUILDING DOCUMENTS, STRUCTURAL AND SERVICES DOCUMENTATION.
- THIS IS NOT AN AS-BUILT DRAWING, AND MAY INCLUDE INACCURACY. PARTIES REQUIRING HIGH LEVELS OF ACCURACY MUST EMPLOY A REGISTERED SURVEYOR TO MEASURE EXISTING.
- CONTRACTOR MUST VERIFY ALL DIMENSIONS ON SITE PRIOR TO COMMENCING WORK OR SHOP DRAWINGS.
- OMISSIONS AND DISCREPANCIES MUST BE REPORTED TO ARCHITECT IMMEDIATELY.
- PRIOR TO COMMENCING DEMOLITION ENSURE ALL POWER IS ISOLATED AND CHECK AGAIN.
- ALL GLAZING TO CONFORM TO AS1288 - 2006.
- ALL LIGHT TIMBER FRAMING TO CONFORM TO AS 1984.1 - 1999.
- NOM. INDICATES A NOMINAL DIMENSION TO BE CHECKED ON SITE.

PROJECT MANAGER
MONTLAUR PROJECT SERVICES
 LEVEL 1, 1 ALBERT STREET RICHMOND VIC 3121
 T +61 3 9421 1900 F +61 3 9421 3600
 E will@montlaur.com.au

CLIENT
ARTS VICTORIA
 T +61 3 9954 5062 E stuart.koop@dpc.vic.gov.au

CLIENT
STATE LIBRARY OF VICTORIA
 328 SWANSTON STREET MELBOURNE VIC 3000
 T +61 3 8664 7293 E ghallowell@slv.vic.gov.au

pvh
 287 Collins Street
 Melbourne Victoria 3000
 T +61 3 9934 7333
 F +61 3 9934 7300
 E melbourne@pvh.com.au

CENTRE FOR BOOKS, WRITING & IDEAS
STATE LIBRARY OF VICTORIA

FURNITURE LAYOUT PLAN LEVEL THREE AND FOUR

Drawn Approved Creation date Plot date Scale	HM/PH pvh 10.12.2008 02.03.2009 1:100 @ A1	Rev C3
Project 2995	Drawing WD501	

FIGURED DIMENSIONS SHALL TAKE PRECEDENCE OVER SCALE. CONTRACTORS MUST VERIFY ALL DIMENSIONS ON JOB BEFORE COMMENCING ANY WORK OR SHOP DRAWINGS. ALL OMISSIONS AND DISCREPANCIES TO BE REPORTED TO peckvonnartel IMMEDIATELY. THIS DRAWING IS PROTECTED BY COPYRIGHT.